


FINAL CONSTRUCTION AS-BUILT
PREPARED FOR E.L.Q. INDUSTRIES

project entitled
"DRURY DRIVE MUNICIPAL DRAINAGE IMPROVEMENTS"
DRURY DRIVE & KNOLLWOOD ROAD
VILLAGE OF MAMARONECK
WESTCHESTER COUNTY, NEW YORK
VOM CONTRACT NO. 2013-03


Situated in the
TOWN and VILLAGE OF MAMARONECK
WESTCHESTER COUNTY
NEW YORK.

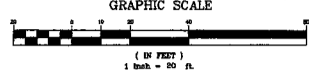

Date: October 27, 2013 Scale: 1"=20'
Vertical Datum: taken from contract documents

RICHARD J. DOMATO
LAND SURVEYOR
Chase Bank Building
22W. First Street-Room 401
Mt. Vernon, N.Y. 10550
(914)667-0565

N.Y.S.L.C. No.049418

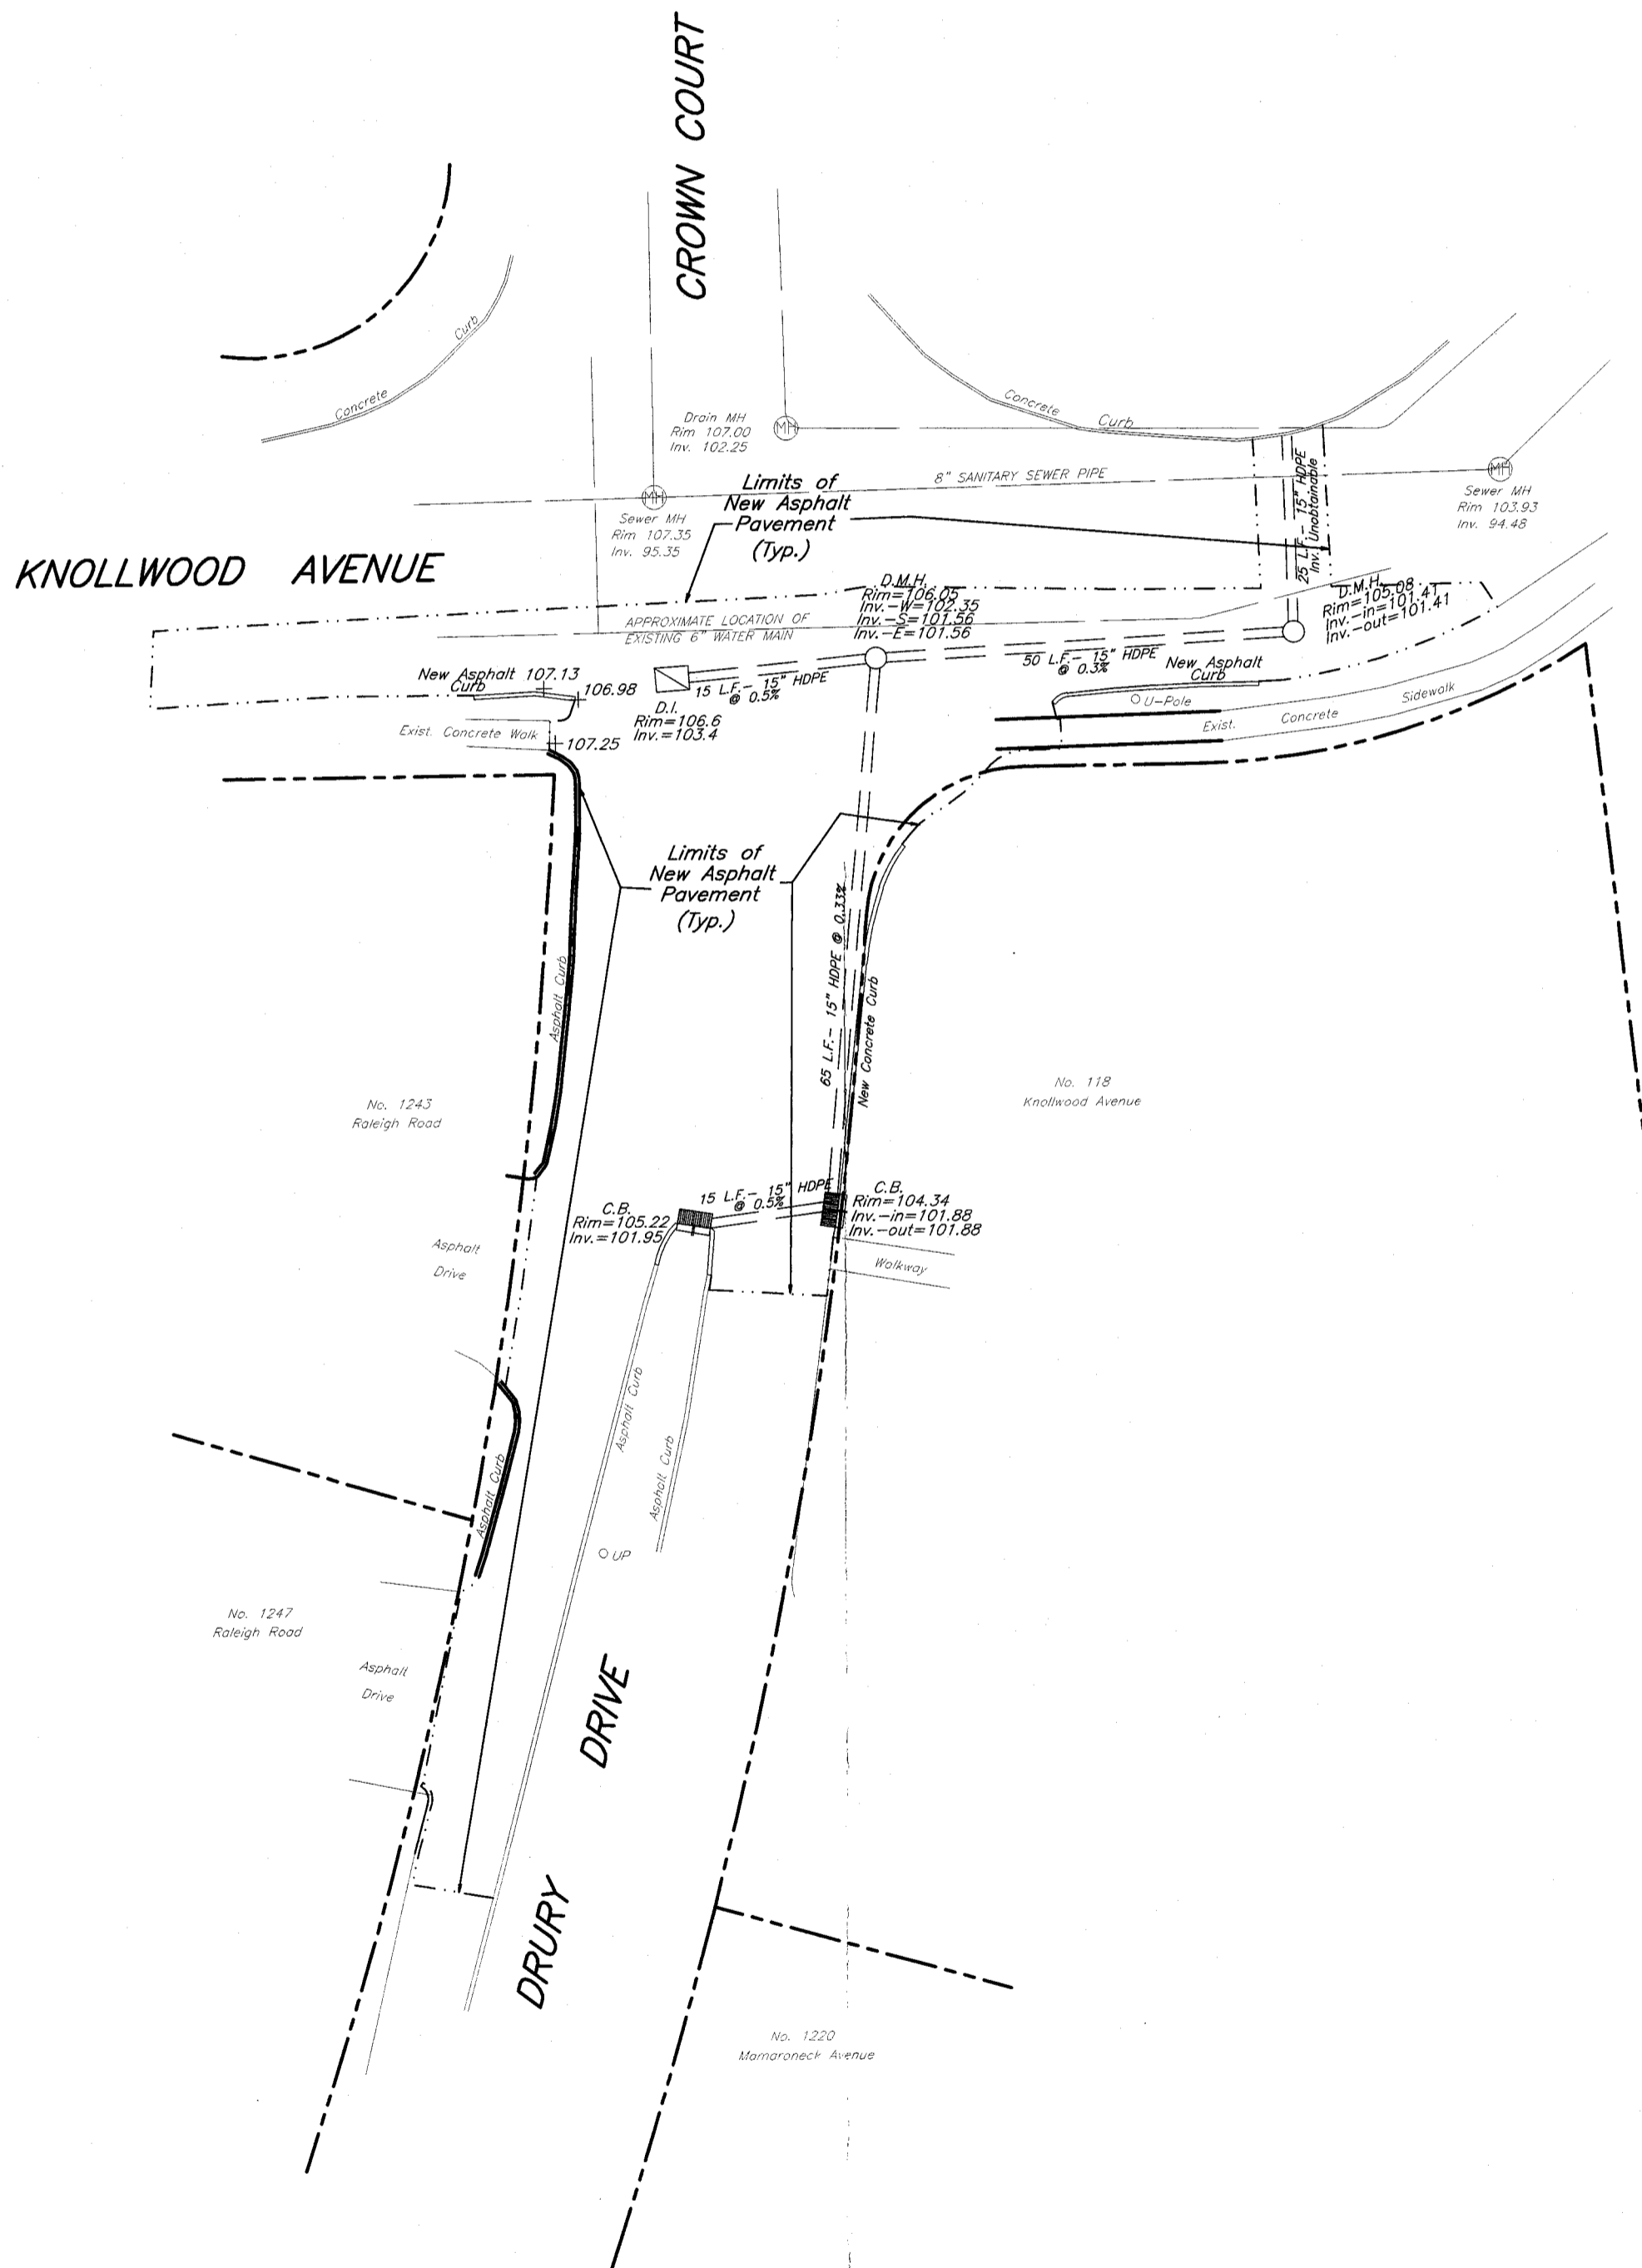

In accordance with the minimum standards for Title Surveys of The N.Y.S. Land Title Assn.

"SURVEYED AS IN POSSESSION"